


6 JOHN STREET

LEGEND

- PROJECT BOUNDARY
- LOTLINES
- PROPOSED SWALE
- BUILDING BOUNDARY
- 107— EXISTING CONTOUR
- x 108.76 EXISTING ELEVATION
- ← OVERLAND FLOW

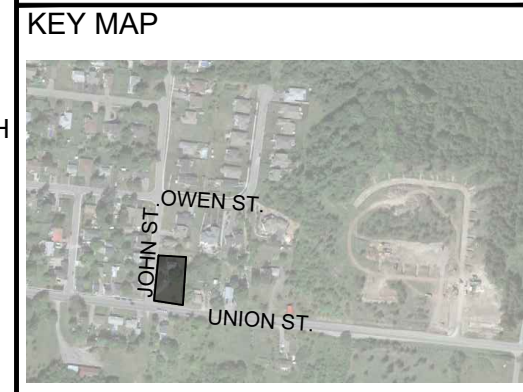

INSITE


PROJECT CONSULTING INC.

REVISIONS

#	M/D/Y	BY	ISSUED FOR

DRAWING TITLE
GRADING AND POST-DEVELOPMENT STORM DRAINAGE PLAN

SCALE 1:300	DWG. NO. 2A
SHEET ANSI B (11" X 17")	

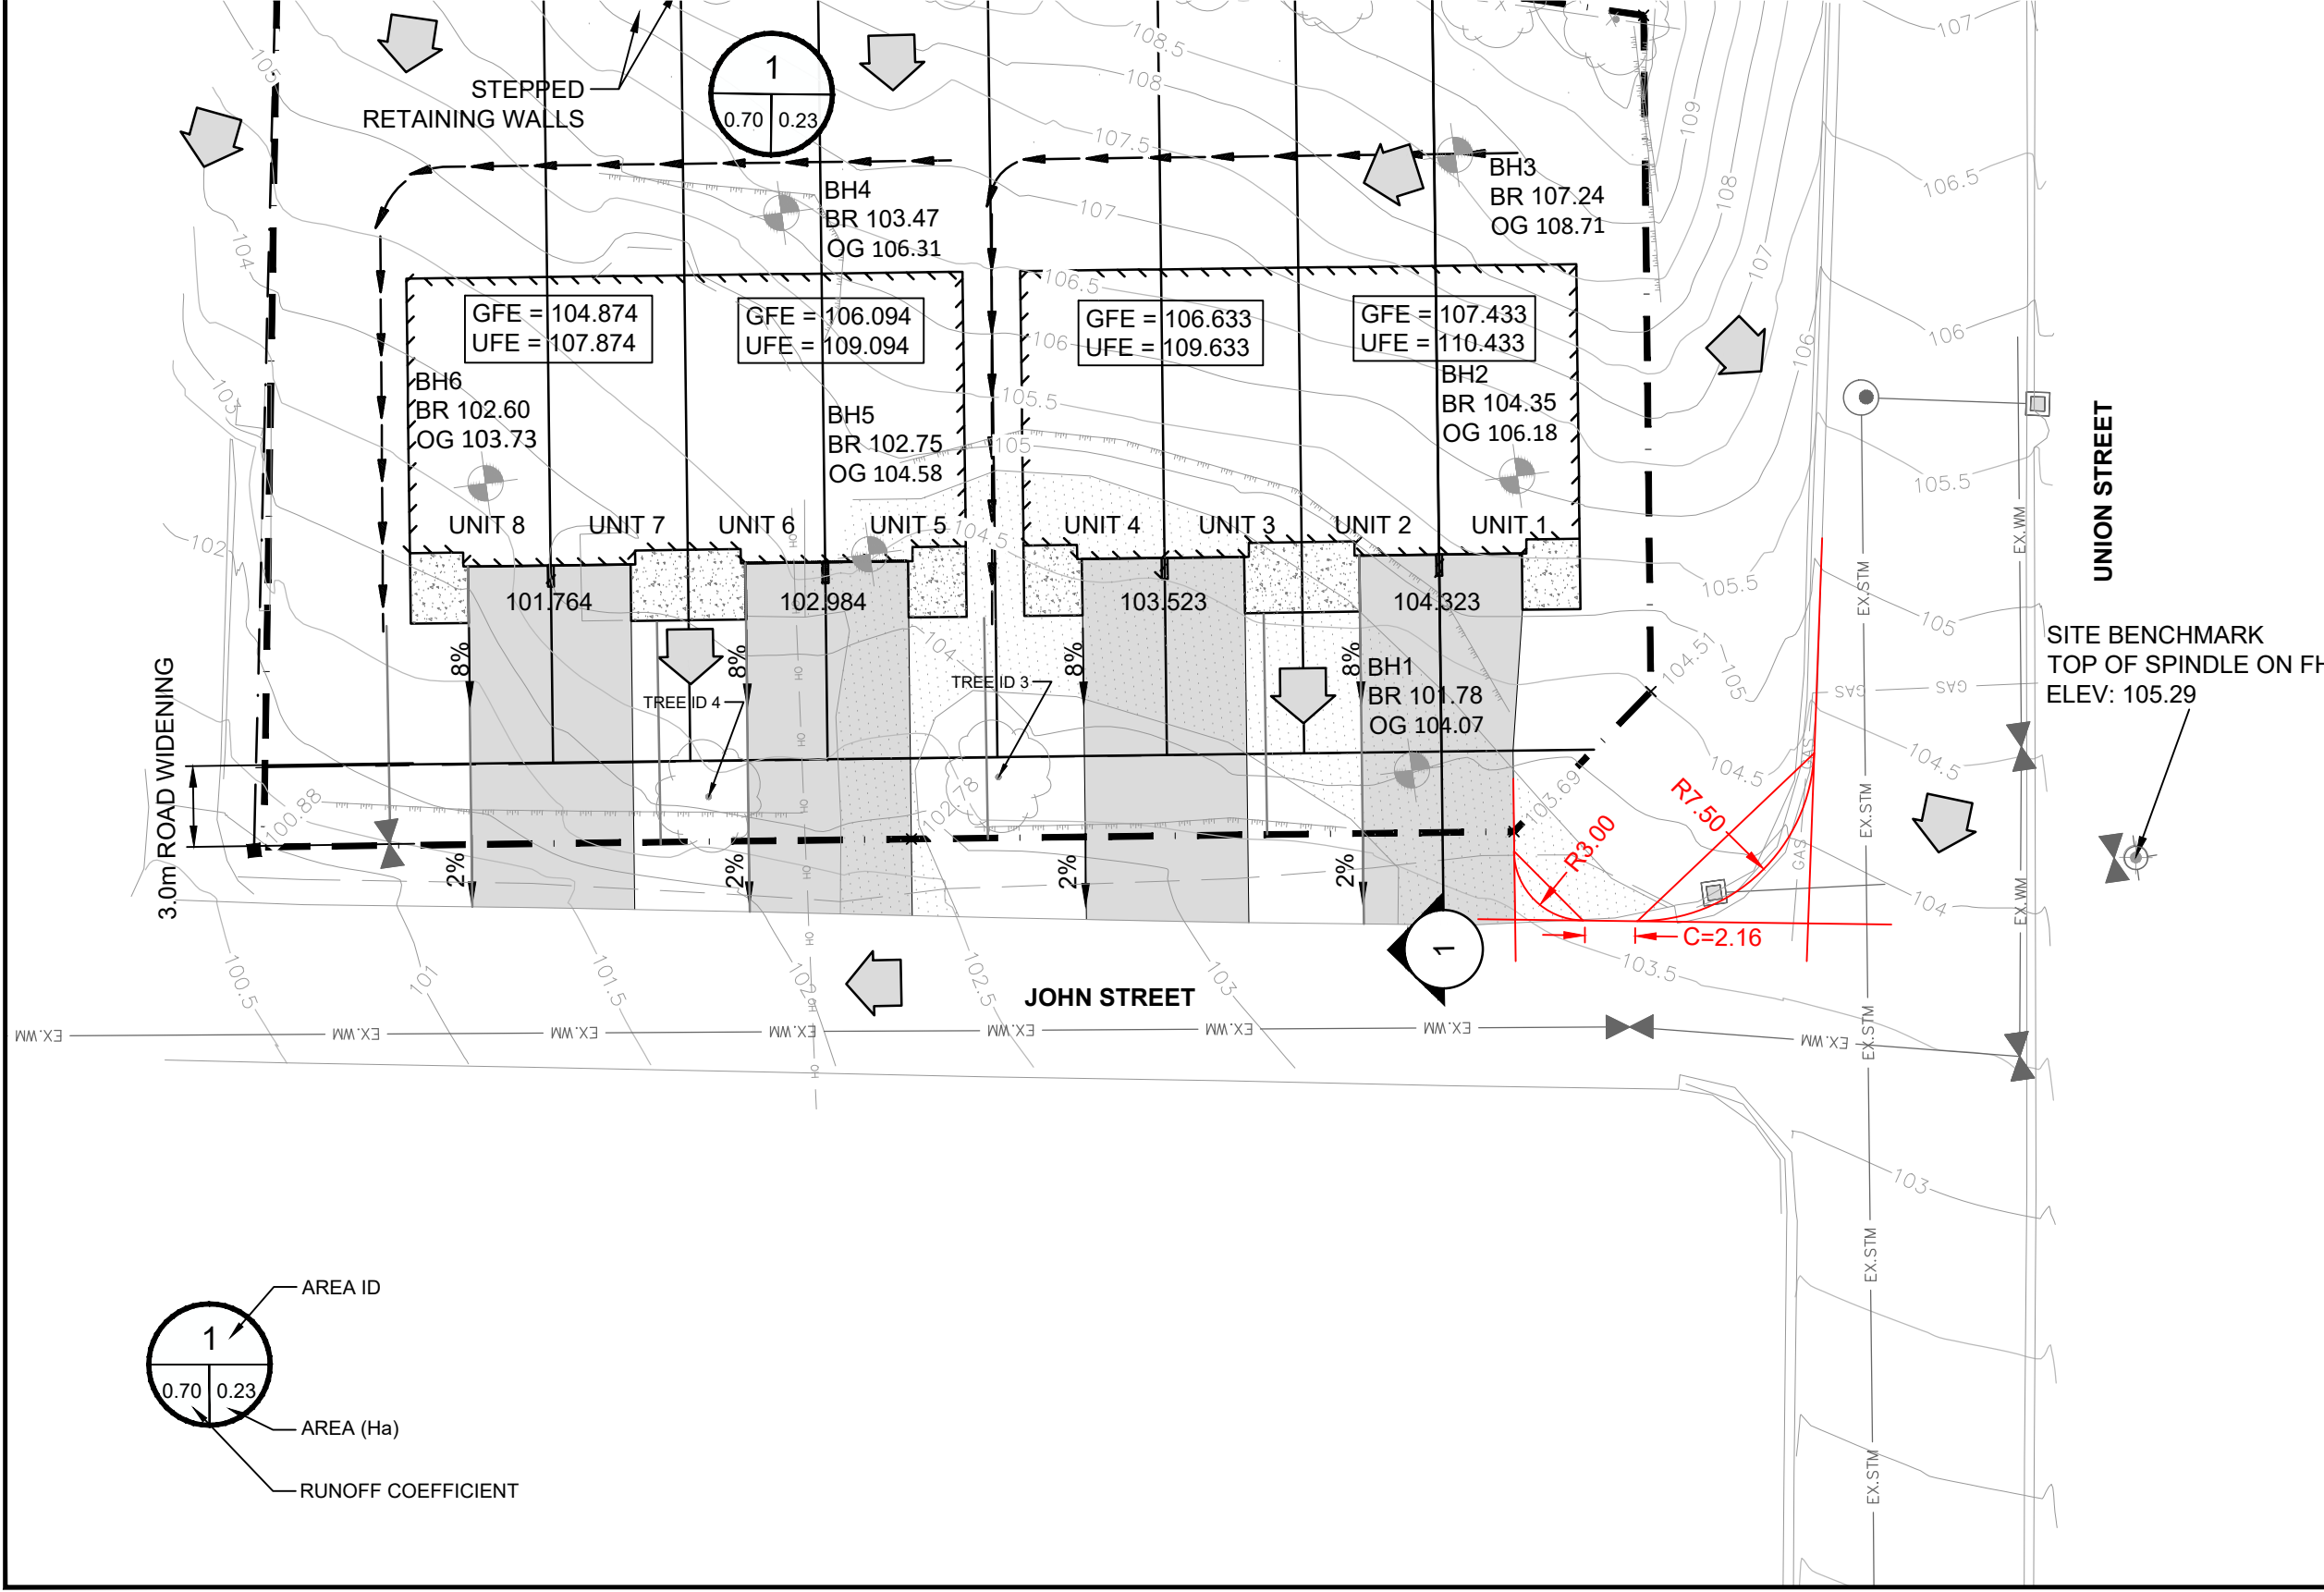

110	STEPPED RETAINING WALLS	110
109	REAR TFW	109
108	107.143	108
107		107

C:\USERS\NHP\INSITE\PROJECT CONSULTING\PROJECT CONSULTING - PROJECTS\23-10 6 JOHN ST\DRAWING FOLDER\6 FIGURE\ENG REPORTS\GRADING PLAN.DWG