



FILE PATH: P:\Belleville Project\6000\1836383 - PEC Property Studies\Working Drawings\18-3-6383 - PEC PROPERTY STUDY - ISSUED TO CLIENT.dwg PLOTTER: Emily LeBlanc
PLOT SCALE: 1:1
DATE PLOTTED: 2021 / 12 / 22 @ 02:47 PM
BORDER SIZE: ISO A1 (841mm x 594mm)


PROPERTY LINES ARE APPROXIMATE ONLY AND ARE
BASED ON OLS SURVEY BY STEWART W ALLEN LTD 1989

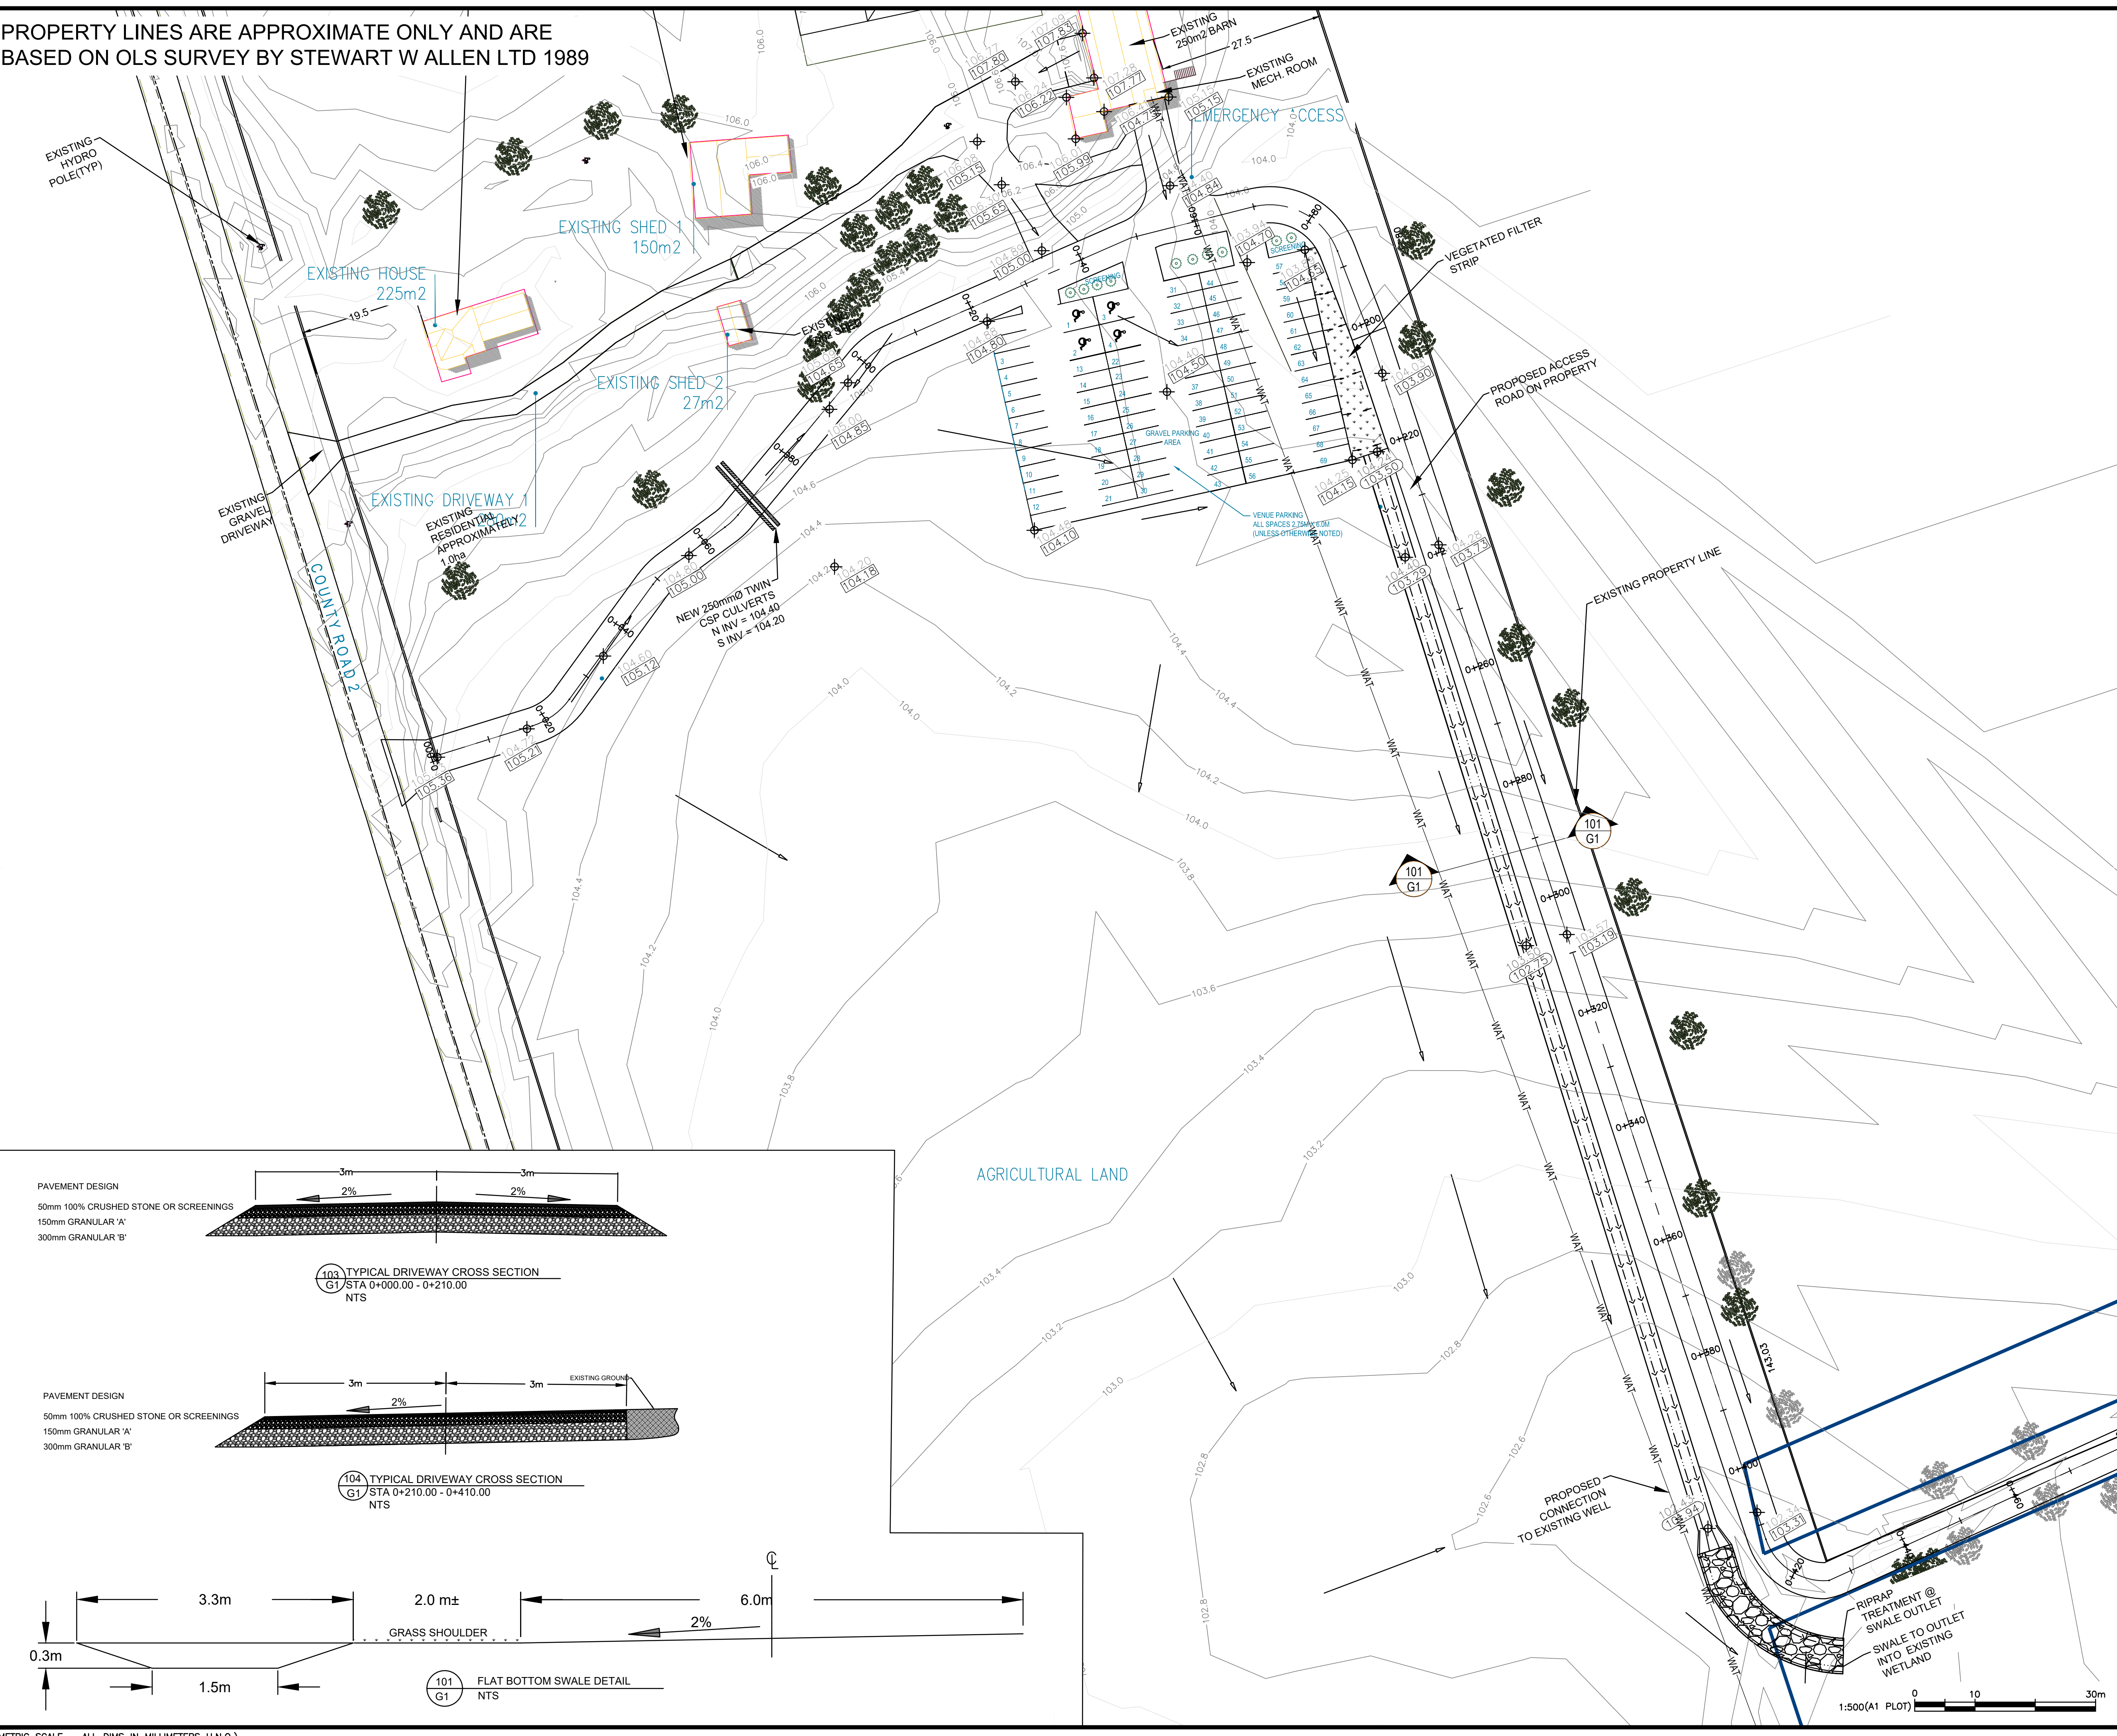


PAVEMENT DESIGN
50mm 100% CRUSHED STONE OR SCREENINGS
150mm GRANULAR 'A'
300mm GRANULAR 'B'

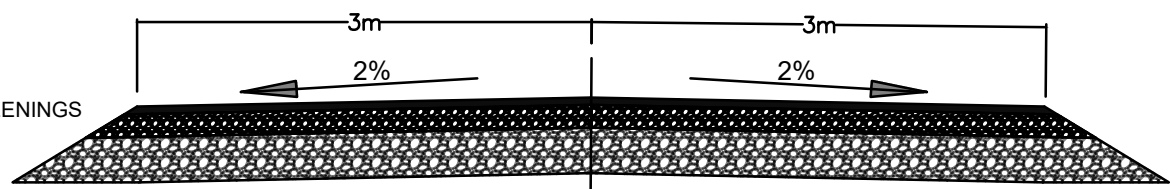

103 TYPICAL DRIVEWAY CROSS SECTION
G1 STA 0+000.00 - 0+210.00
NTS

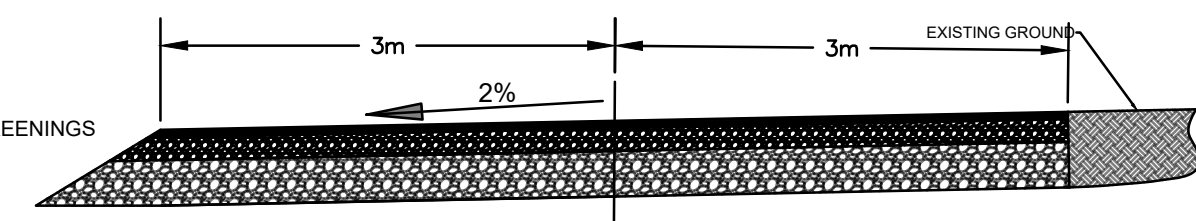

104 TYPICAL DRIVEWAY CROSS SECTION
G1 STA 0+210.00 - 0+410.00
NTS

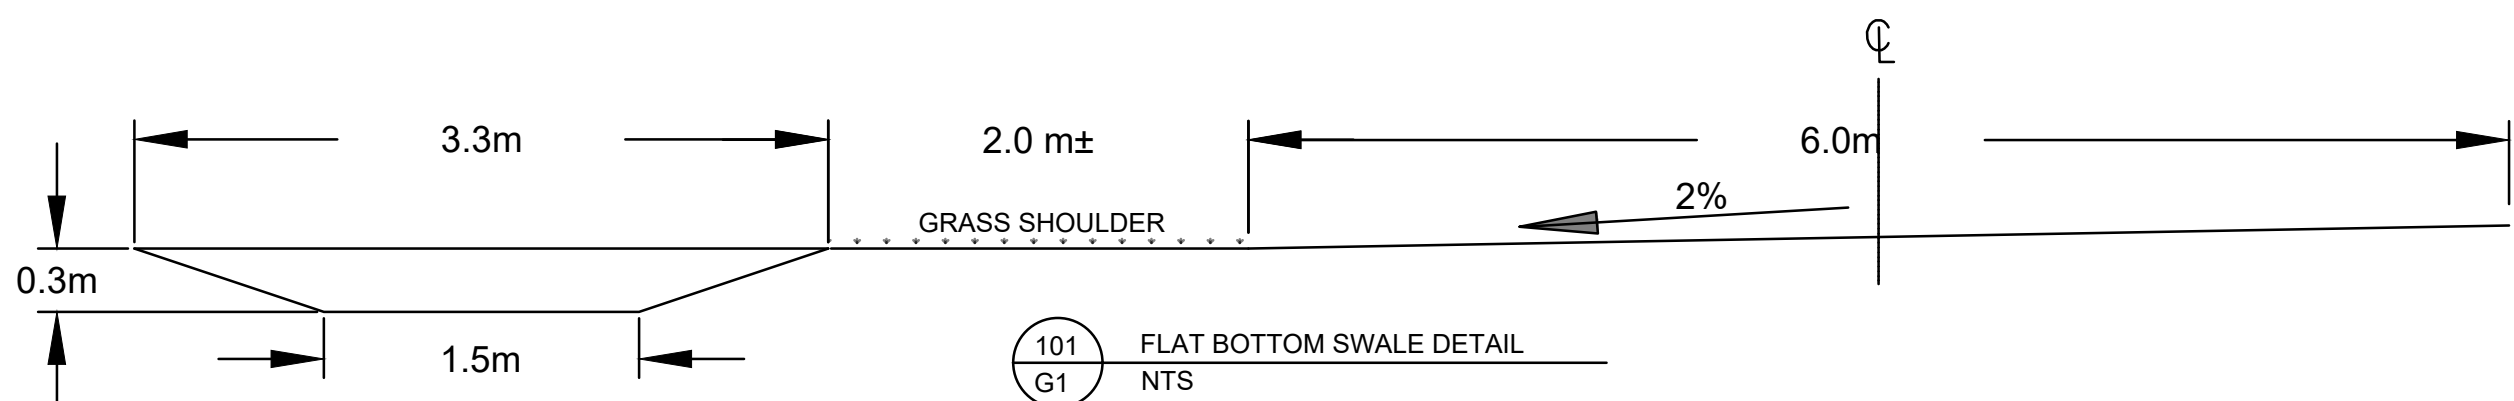

101 FLAT BOTTOM SWALE DETAIL
G1
NTS

(METRIC SCALE - ALL DIMS IN MILLIMETERS U.N.O.)




GREER GALLOWAY
CONSULTING ENGINEERS
PETERBOROUGH
BELLEVILLE
KINGSTON
1620 WALLBRIDGE LOYALIST ROAD
BELLEVILLE, ONTARIO, K8N 4Z5
PHONE: 613-966-3068
FAX: 613-966-3087

- NOTES:
1. ALL WORK SHALL BE IN ACCORDANCE WITH RELEVANT CODES AND GUIDELINES.
 2. ALL DRAWINGS AND ADDENDA ARE TO BE READ AS, AND IN CONJUNCTION WITH THE SPECIFICATIONS.
 3. ALL EQUIPMENT SHALL BE INSTALLED AS SPECIFIED OR APPROVED EQUIVALENT.
 4. CONTRACTOR MUST CHECK AND VERIFY ALL DIMENSIONS BEFORE PROCEEDING WITH WORK AND BE RESPONSIBLE FOR SAME.
 5. CONTRACTOR MUST REPORT ANY DISCREPANCIES TO ENGINEER FOR RESOLUTION BEFORE COMMENCING THE WORK.
 6. ANY CHANGES MUST BE APPROVED BY THE ENGINEER.

A	A DETAIL NO.
B	B DRAWING NO. - WHERE DETAILED

03	AS-BUILT	21/12/22
02	REVISED PER COMMENTS	20/09/25
01	SITE PLAN APPROVAL	20/08/13
REVISION	DESCRIPTION	DATE

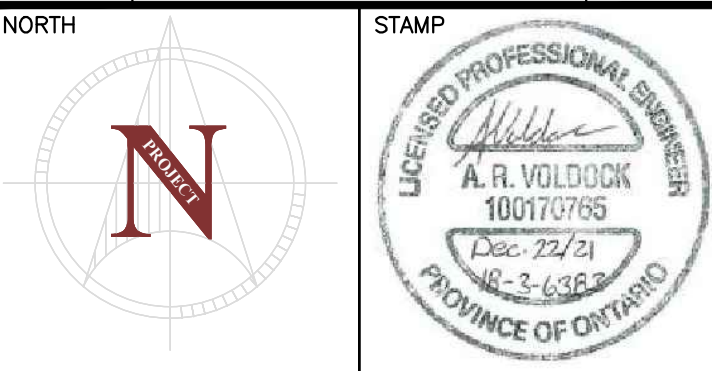

PROJECT
SCHNURR PROPERTY DEVELOPMENT
1244 COUNTY ROAD 2
PARTS 1 AND 2 OF LOT 18, PLAN 33
HALLOWELL TOWNSHIP
PRINCE EDWARD COUNTY

JESSICA SCHNURR
DRAWING TITLE
GRADING PLAN

DESIGNED BY
JB

DRAWN BY
SA/NW

REVIEWED BY
JB

APPROVED BY
AV

PROJECT DATE
2019/03/15 (YYY/MM/DD)

PROJECT #
18-3-6383

DRAWING # G1	DRAWING SCALE (ISO A1) HOR: 1:500 (A1 PLOT) VER: X : XXX
-----------------	--