
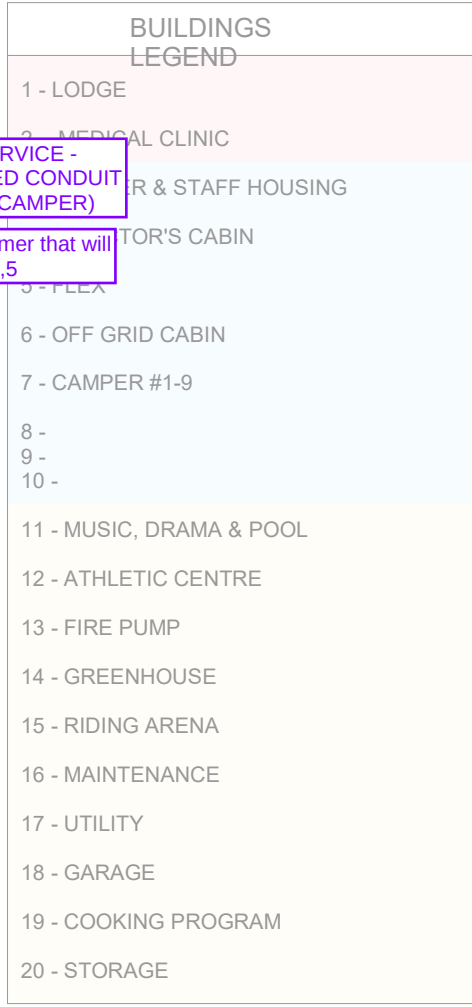
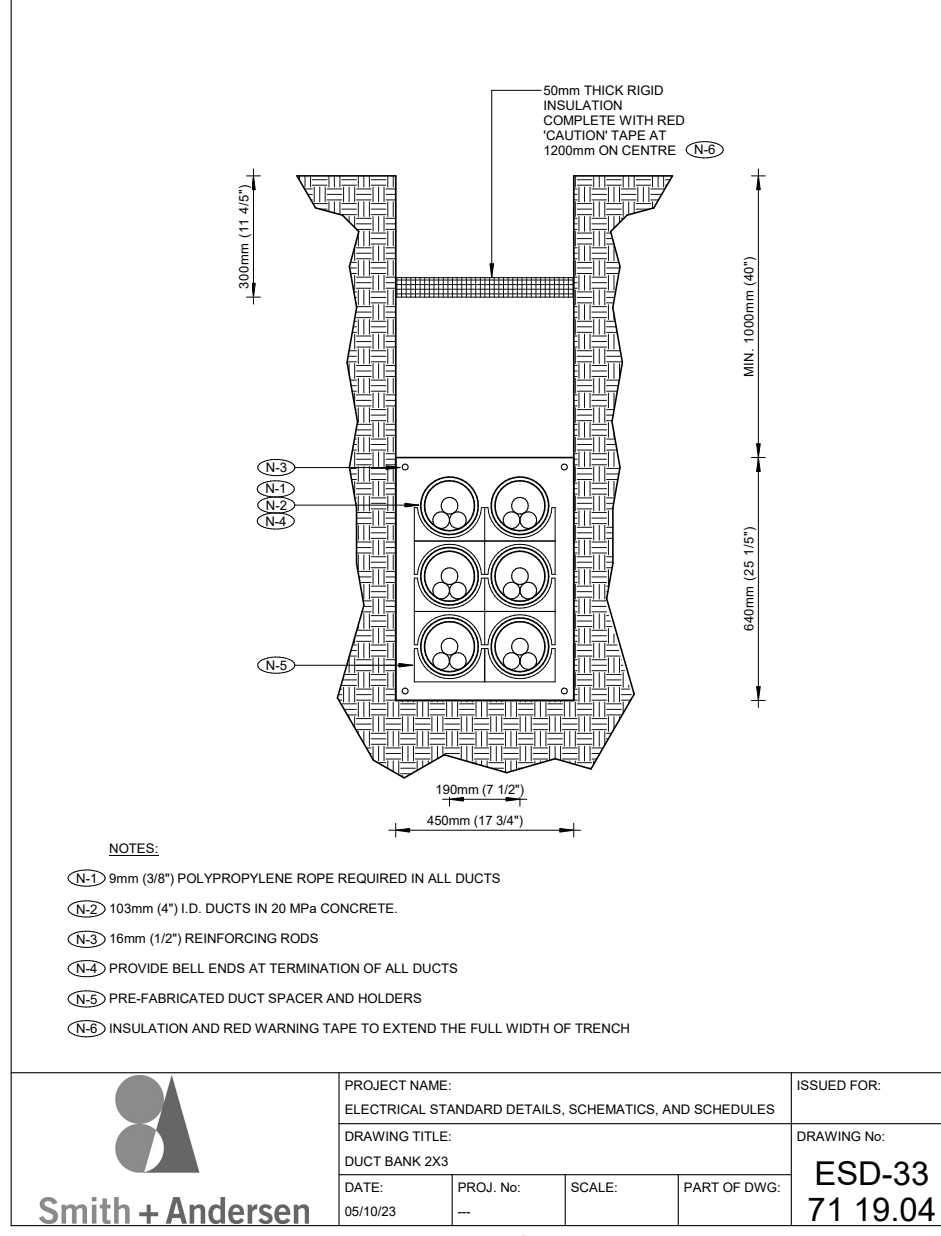


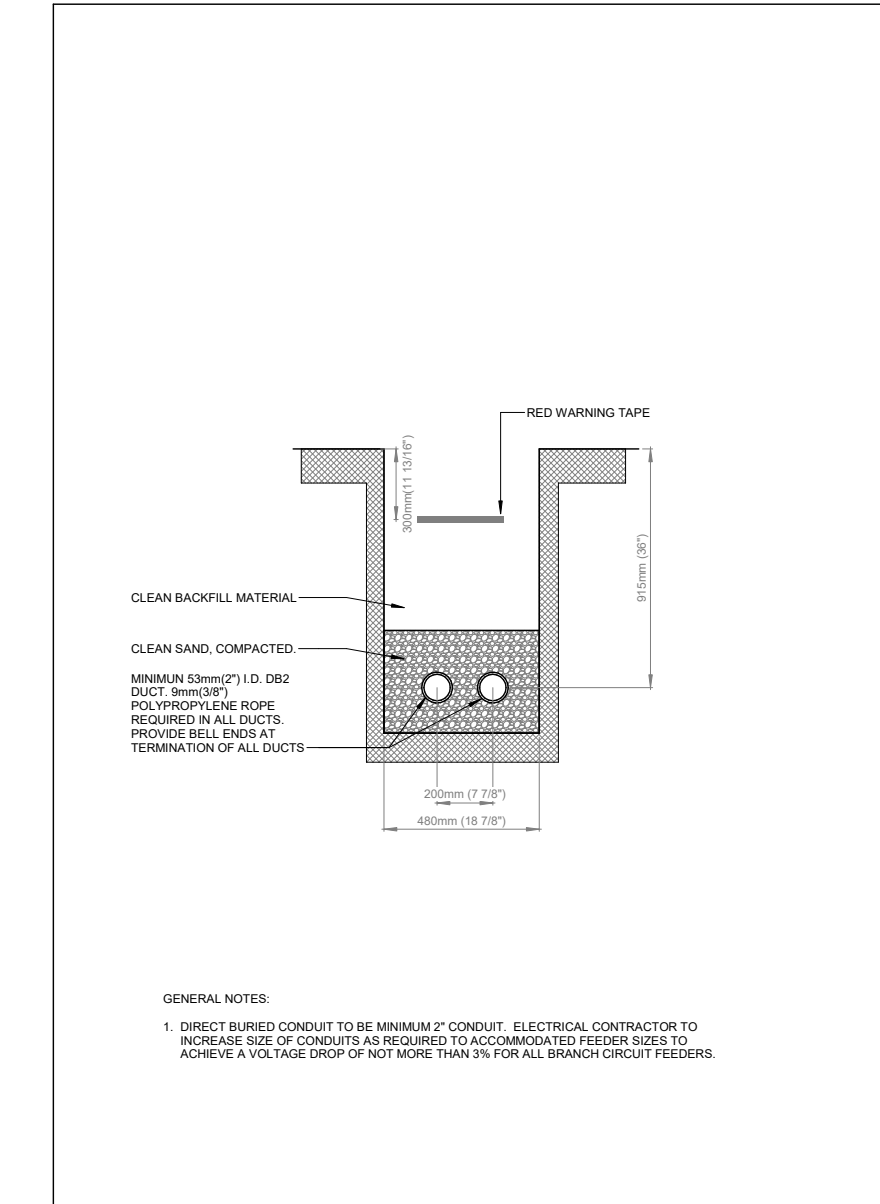

All drawings, specifications, related documents and design are the copyright property of the architect and must be returned upon request. Reproduction of the drawings, specifications, related documents and design in whole or in part is strictly forbidden without the architect's written permission.

This drawing, as an instrument of service, is provided by and is the property of Teeple Architects Inc., and shall be used only for the project named on this drawing and solely for reference purposes only. The contractor is responsible for the coordination and verification of all dimensions contained herein and all measurements and conditions on site as they pertain to these documents. The contractor shall report any discrepancies to the consultant in writing prior to the commencement of any affected work.



DO NOT SCALE THIS DRAWING

This drawing shall not be used for construction purposes unless countersigned

General Comments:

- 1) Location of pad mounted transformers can be shifted and coordinated further based on best location for the program space.
- 2) Assumed electrical rooms in some building. If this is not possible, then alternative distribution may need to be determined. This may have an impact on the proposed mechanical system for these buildings.
- 3) Routing can be adjusted to avoid interferences, clashes, etc.
- 4) Duct banks are being proposed for all main services to building. For cost savings, alternative method can be explored.

[illegible]

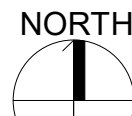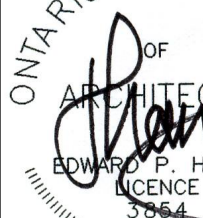CLIENT Campfire Circle 464 Bathurst St. Toronto, ON M5T 2S6	 CAMPFIRE CIRCLE HEALING THROUGH HAPPINESS
565 Wesley Acres Rd Bloomfield, Ontario K0K 1G0	
 PLAN NORTH  ONTARIO ASSOCIATION OF ARCHITECTS EDWARD P. HANDY LICENSE 57844 SEAL	
DRAWN BY JM	CHECKED BY RK
PROJ NO TAI: 23-105	SCALE As indicated
ARCH D ARCH D	PLOT DATE 09/10/15