



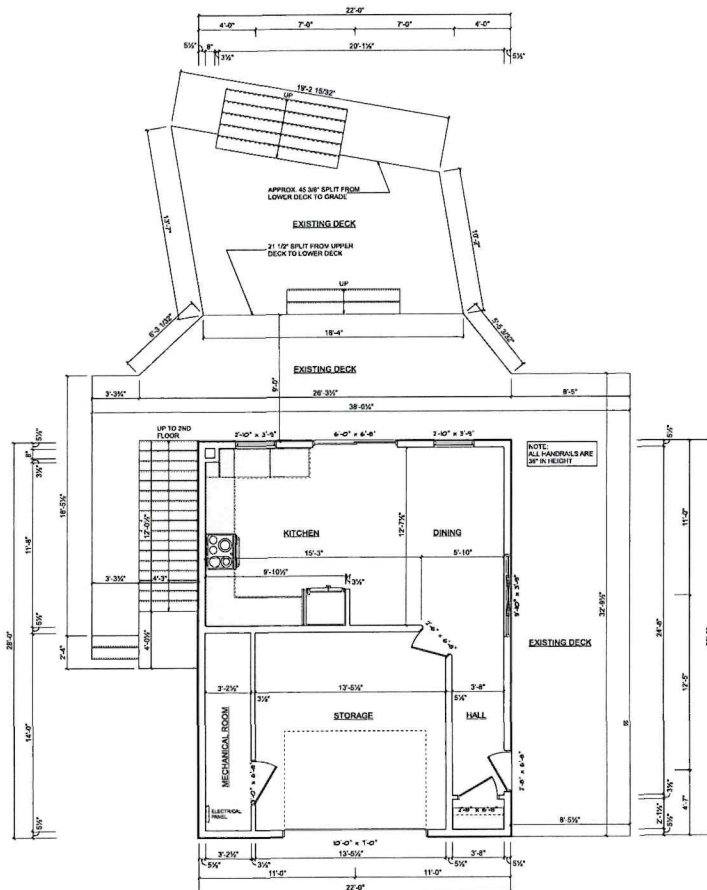

MAIN FLOOR PLAN
SCALE: 1/4" = 1'-0"
FLOOR AREA: 616 SQ. FT.

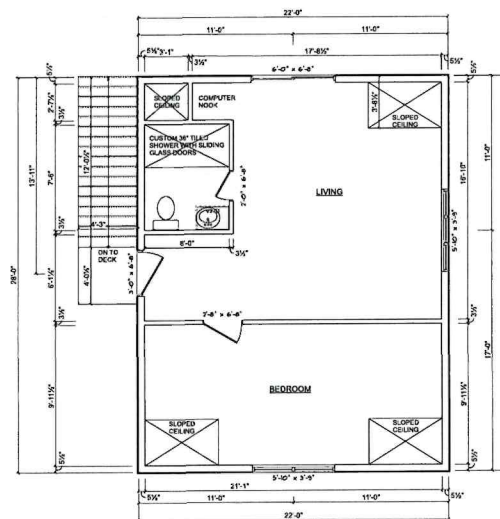

SECOND FLOOR PLAN
SCALE: 1/4" = 1'-0"
FLOOR AREA: 616 SQ. FT.



Picton Home Hardware Building Centre
13544 Loyalist Parkway
Picton, ON K0K 2T0
Ph: (613) 476-7497
Fax: (613) 476-1614

THE UNDERSIGNED HAS REVIEWED AND TAKES RESPONSIBILITY FOR THIS DESIGN, AND HAS THE QUALIFICATIONS AND MEETS THE REQUIREMENTS SET OUT IN THE ONTARIO BUILDING CODE TO BE A DESIGNER.

QUALIFICATION INFORMATION
(Required unless design is exempt under division C, subsection 3.2.5 of the O.B.C.)

NAME: Dan Gannon SIGNATURE: [Signature] BCN: 23968

REGISTRATION INFORMATION
Registered under design is exempt under division C, subsection 3.2.4 of the O.B.C.

23968 Ontario Inc. as DMG Design 23968 BCN

No.	Revision	Date

Project
AS BUILT CARRIAGE HOUSE
WITH DECK & GAZEBO
FOR TYRMAN
7 CARLS LANE, PEC

Drawing
MAIN FLOOR PLAN
SECOND FLOOR PLAN

Drawn By
Dan Gannon

Project No.	Sheet No.
2612	A1
Date AUG. 25, 2026	
Scale 1/4" = 1'-0"	